


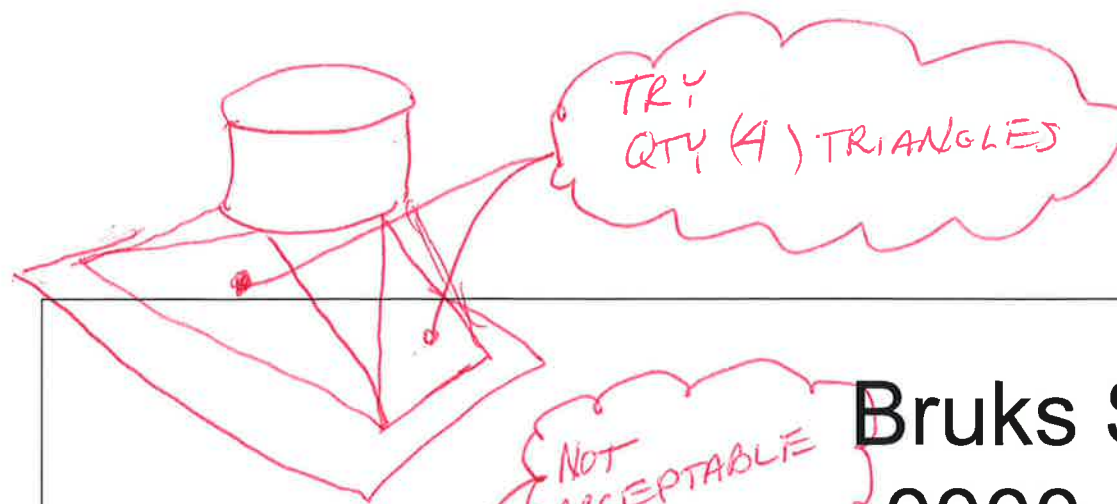


TRY
QTY (4) TRIANGLES


NOT
ACCEPTABLE

TEH 11/7/2012


Bruks SO#19178 0000-GCI-0615

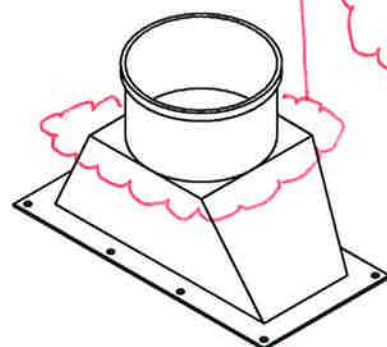


Isometric View

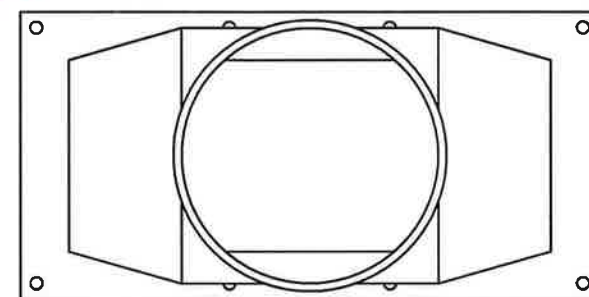

Top View

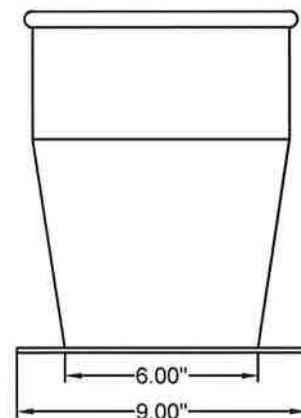


Left View

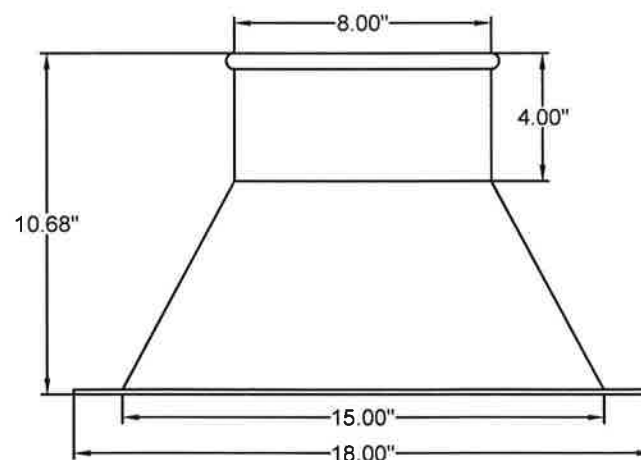

Front View

Notes:

1. Connect to 8" K&B rolled end
2. Material is 0.14" Galvanized Steel
3. Shall be marked with non-destructive tag: "0000-GCI-0615"

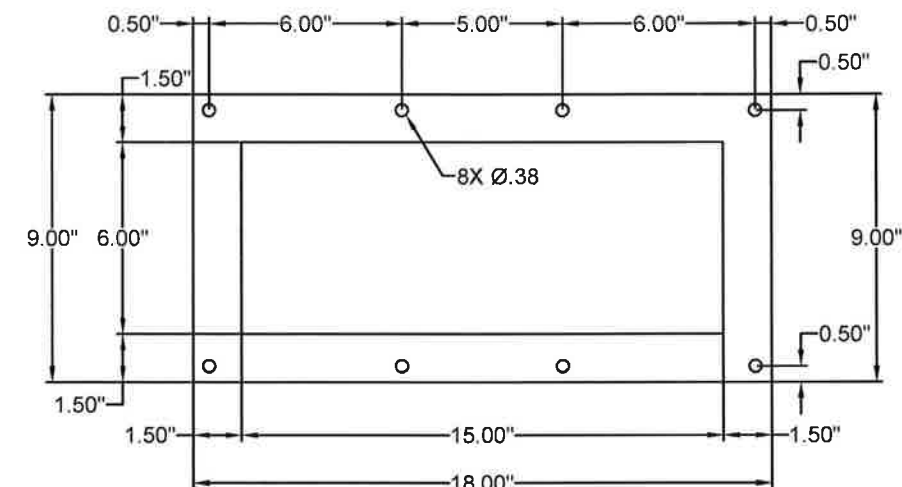

Flanged View

Avani Environmental Intl. 95 Cypress Drive Youngsville, NC 27596 P# 919-570-2862 F# 919-570-2863		Avani
Project: Bruks SO#19178 Drawing: 0000-GCI-0615		
Date: 11/1/12	Drawn by:MDT	
Sheet No: 1 Of 1	Rev.: 0	