



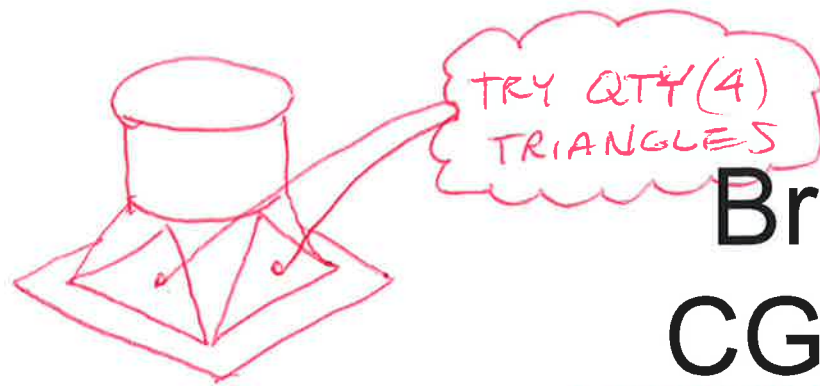


Bruks SO#19178

CGI-136-RCT-8RD

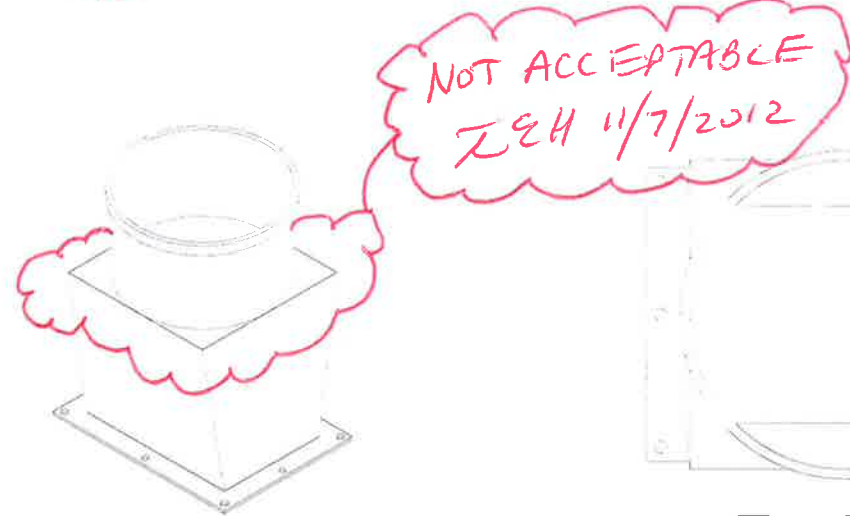


Isometric View

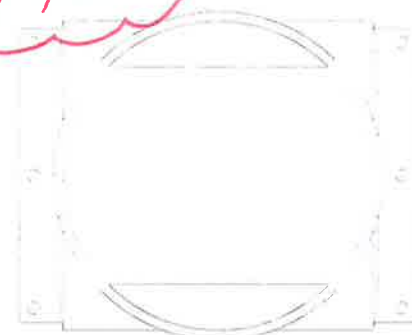


Top View



Left View

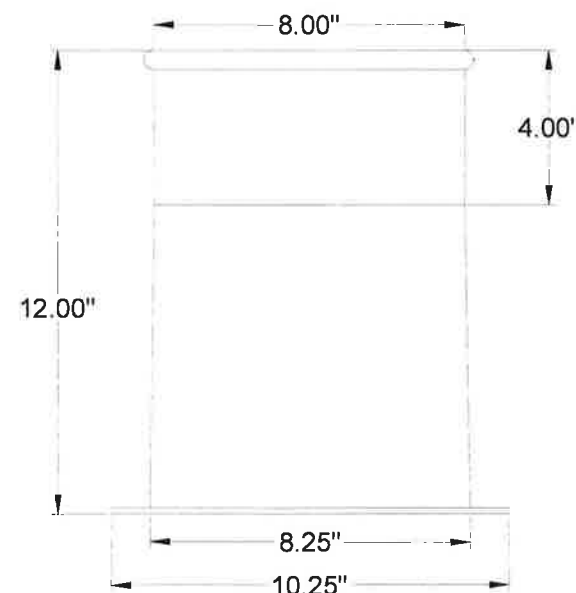

Front View

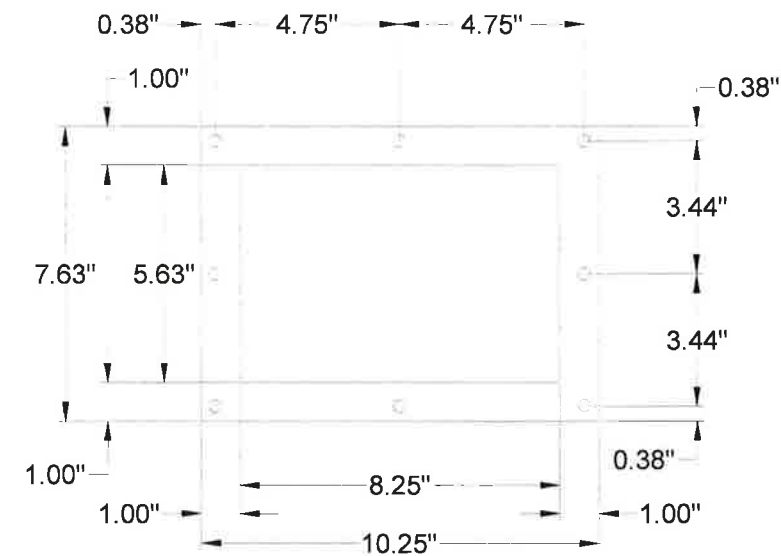

Flanged View

Notes:

1. Connect to 8" K&B rolled end
2. Material is 0.14" Galvanized Steel
3. Shall be marked with non-destructive tag: "CGI-136-RCT-8RD"

Avani Environmental Intl.
95 Cypress Drive
Youngsville, NC 27596
P# 919-570-2862 F# 919-570-2863

Avani

Project: Bruks SO#19178

Drawing: CGI-136-RCT-8RD

Date: 11/1/12

Drawn by:MDT

Sheet No: 1 of 1

Rev.: 0