

ABSOLENT AB
ODR3000
UL




JE Automation

CIRCUIT DIAGRAM

STATUS	AS BUILT	
CONT. SH.	2	SHEET 1
DRW. NO.	934_6	REV.

DESIGN.	AW	DRAWN	AW	ESTABL.		FILE NAME	
DATE	2004-06-18	APPR.		DEPT.	+AS1	A NO.	

REV.	DESCRIPTION	SIGN.	DATE

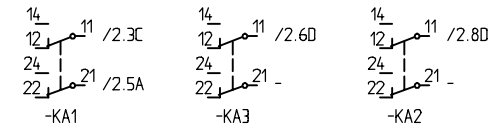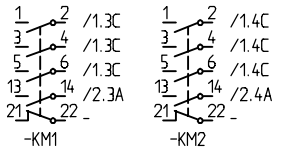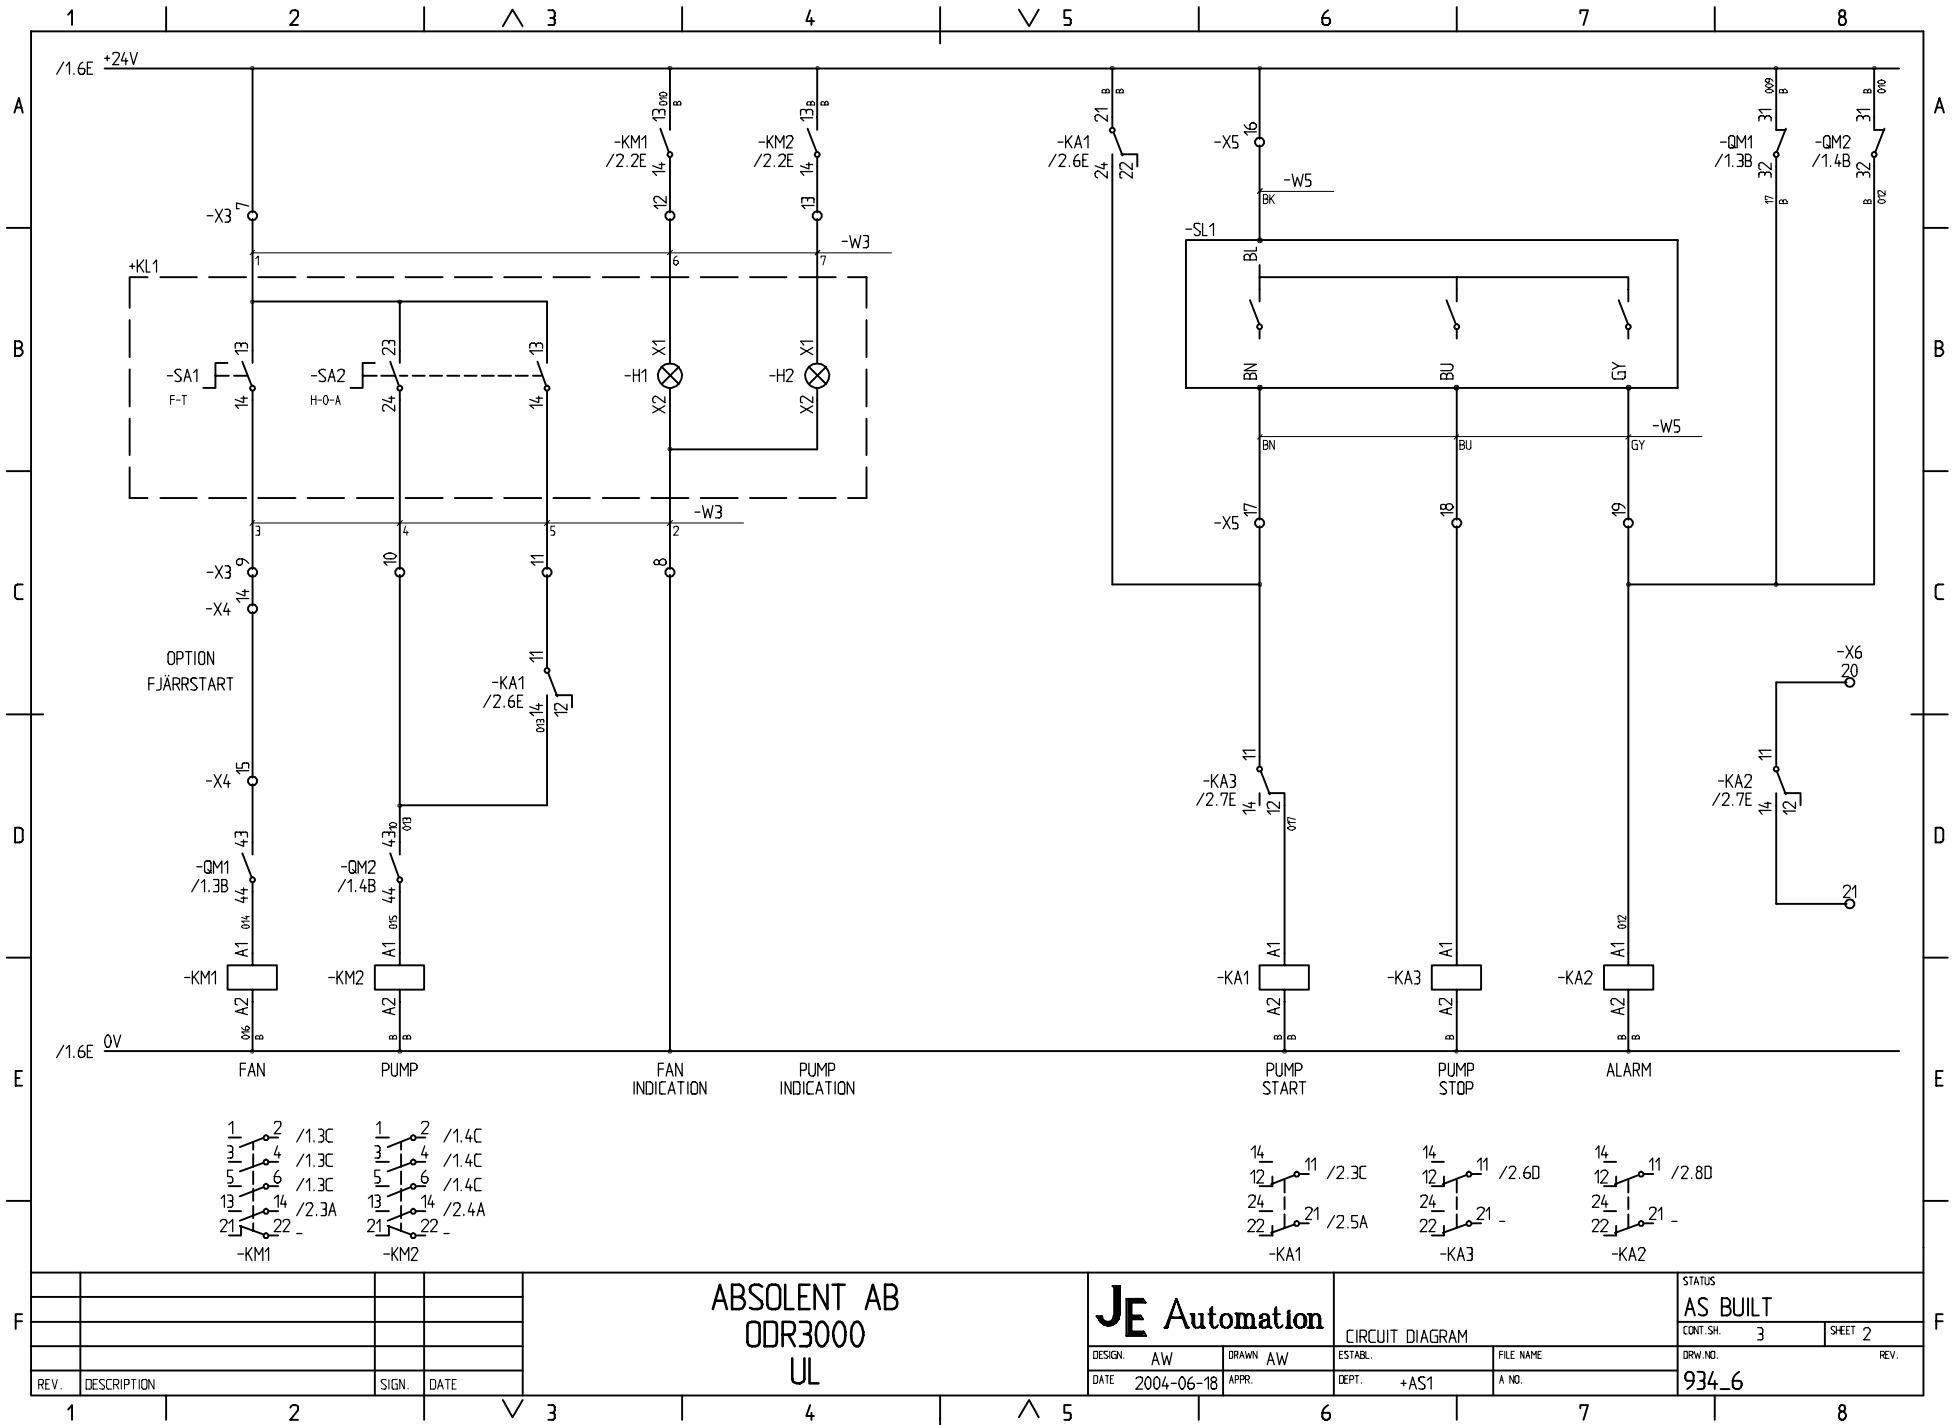

ABSOLENT AB
ODR3000
UL


JE Automation

CIRCUIT DIAGRAM


STATUS	
AS BUILT	
CONT. SH. 3	SHEET 2
DRW. NO.	REV.
934_6	

REV.	DESCRIPTION	SIGN.	DATE

DESIGN. AW	DRAWN AW	ESTABL.	FILE NAME
DATE 2004-06-18	APPR.	DEPT. +AS1	A NO.

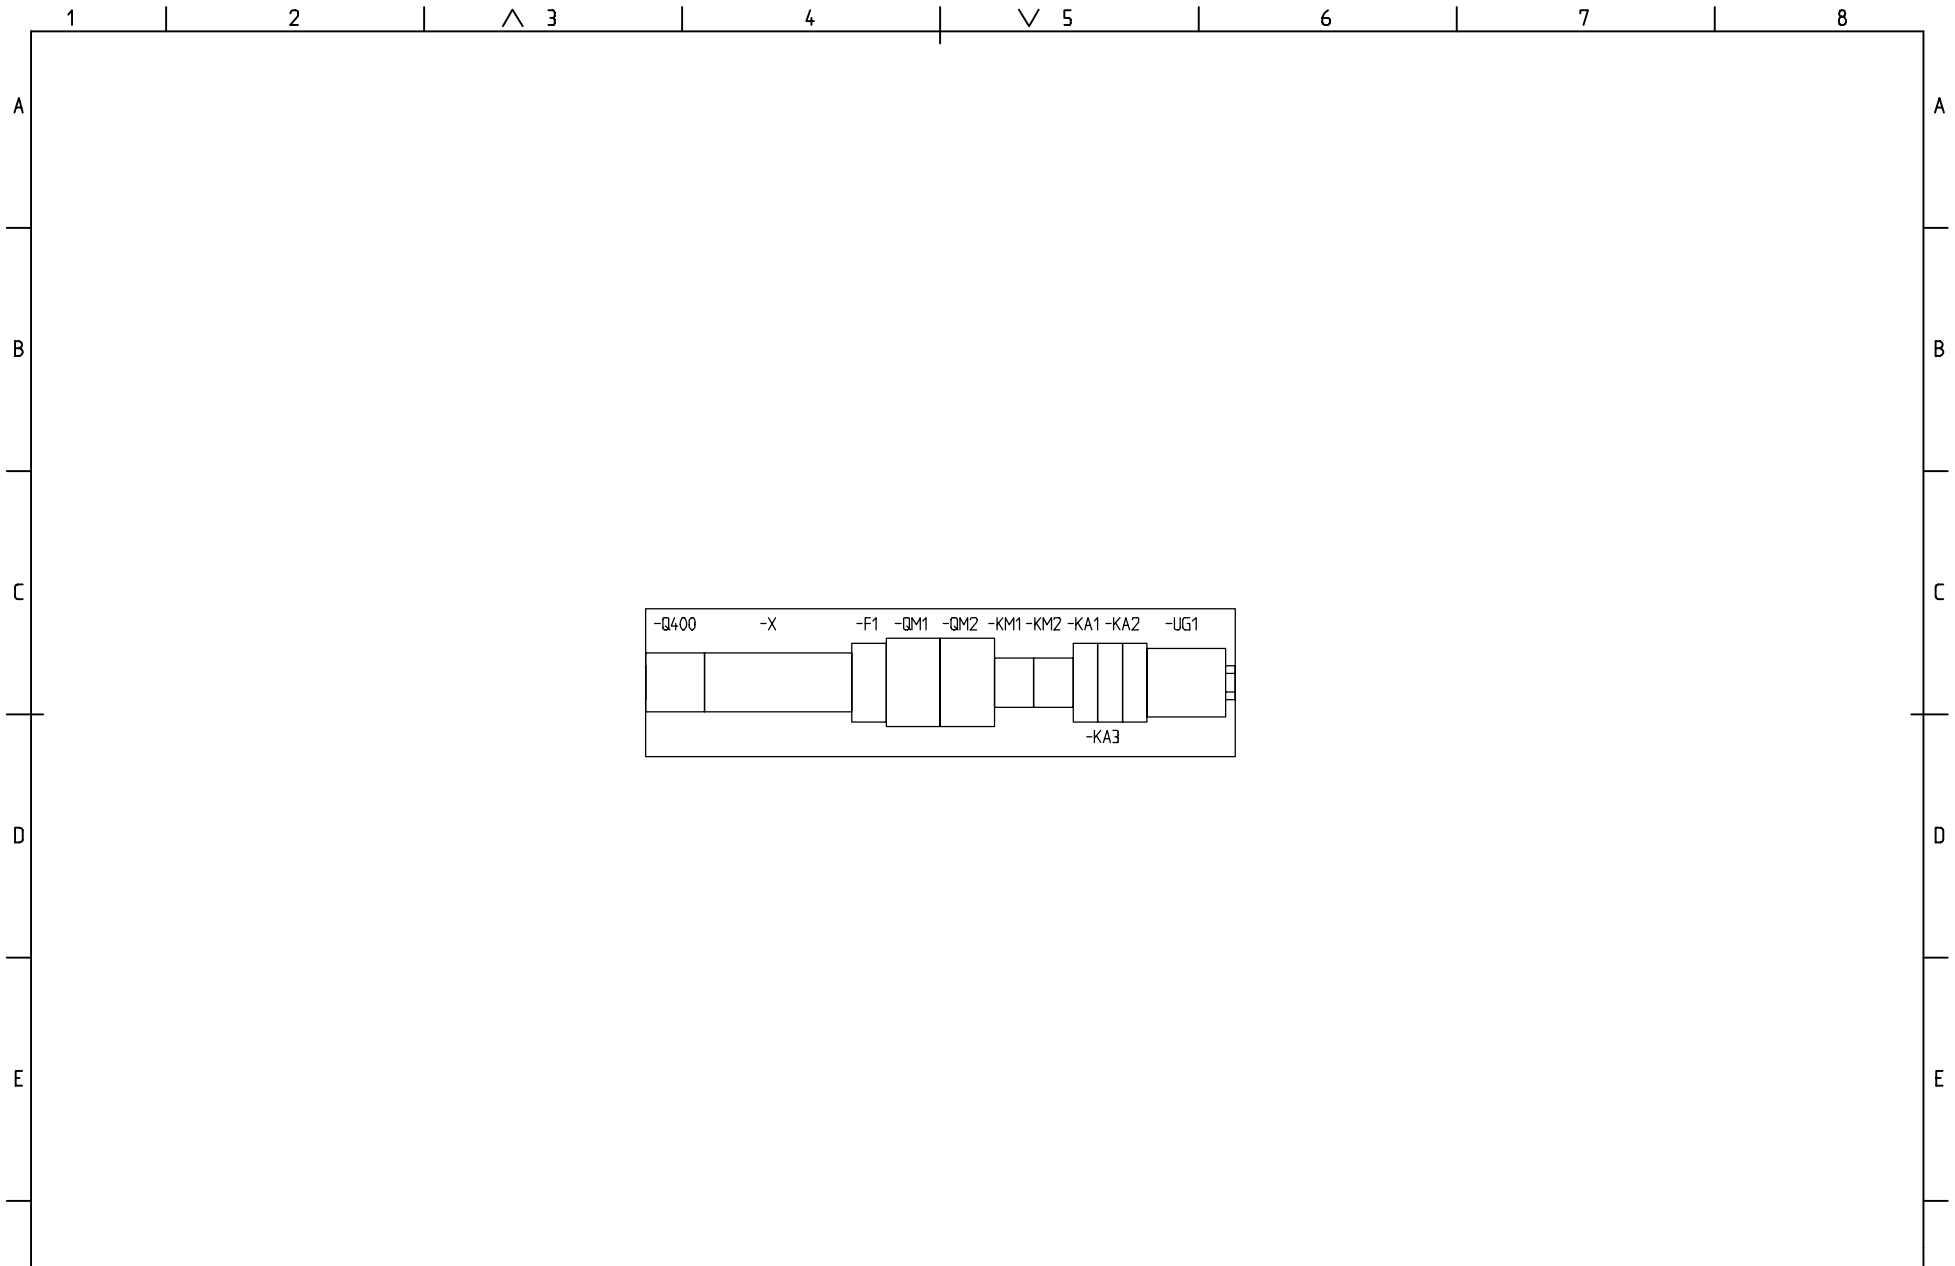

				ABSOLENT AB ODR3000 UL			JE Automation LAYOUT		STATUS AS BUILT		
									ESTABL. +AS1		FILE NAME A NO.
REV.	DESCRIPTION	SIGN.	DATE			DESIGN.	DRAWN	DATE	APPR.	DEPT.	A NO.
						AW	AW	2004-06-18			

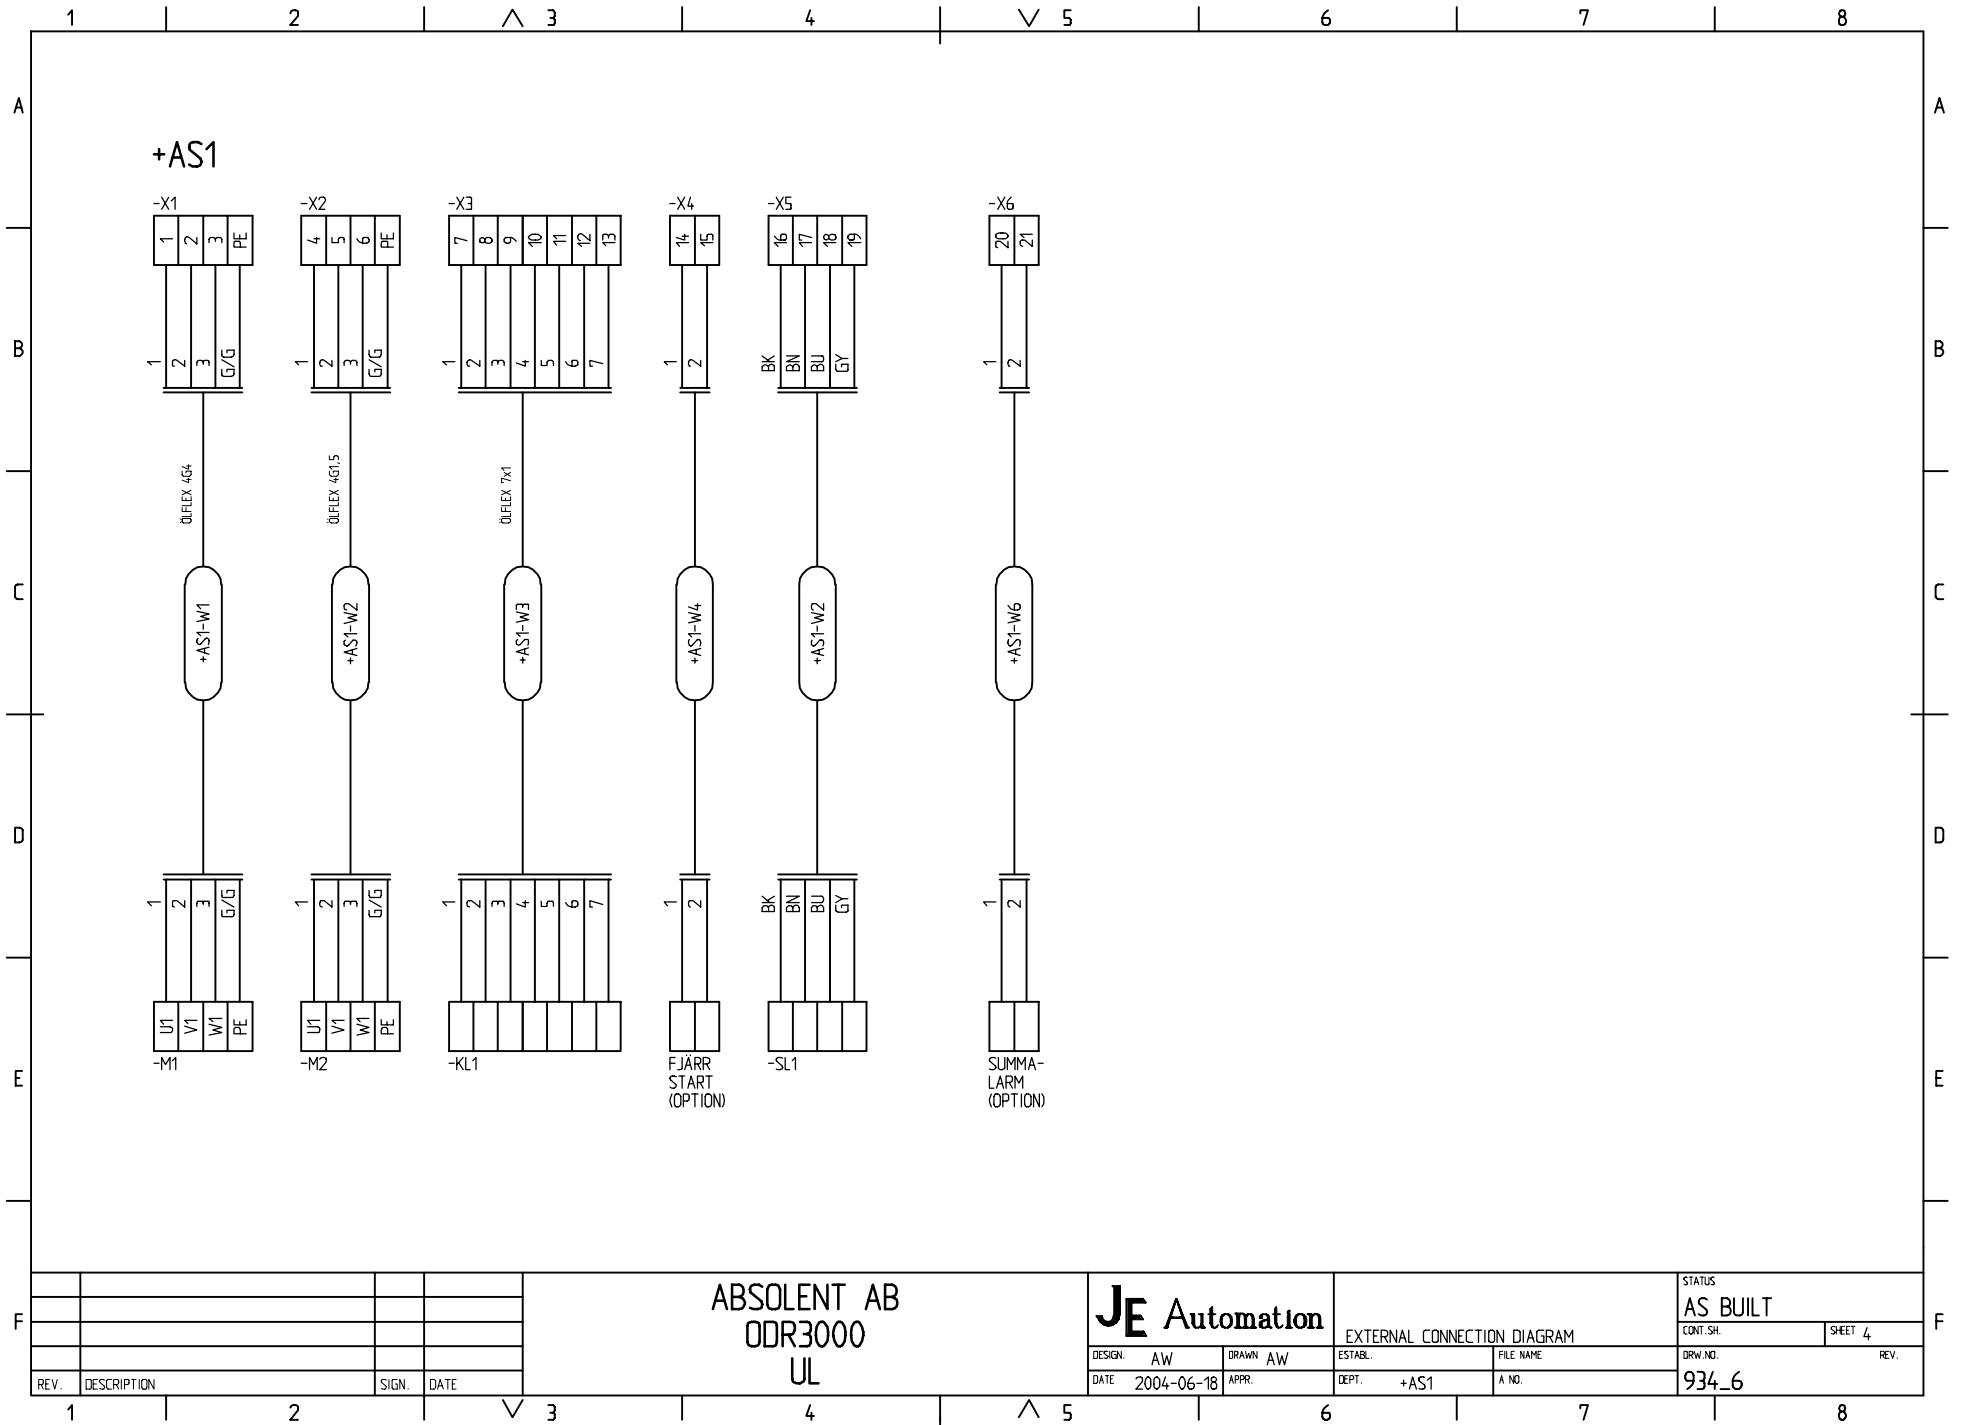

ABSOLENT AB
ODR3000
UL

JE Automation

EXTERNAL CONNECTION DIAGRAM

STATUS AS BUILT	
CONT. SH.	SHEET 4
DRW. NO.	REV.
934_6	

DESIGN.	AW	DRAWN	AW	ESTABL.		FILE NAME	
DATE	2004-06-18	APPR.		DEPT.	+AS1	A NO.	

REV.	DESCRIPTION	SIGN.	DATE

Line	Item	Denomination	Technical Data	Manufacturer	Type No.	Order No. E-number	Sheet ref.	Index	Remark	Rev.
1										
2	-Q400	Huvudbrytare Main Switch Hauptschalter	25A	Vario	VBD1					
3	-QM1	Motorskydd Motor Circuit Breaker Leistungsschalter	13-18A	Telemecanique	GV2-M20+ GV2 AE11					
4	-QM2	Motorskydd Motor Circuit Breaker Leistungsschalter	1-1,6A	Telemecanique	GV2-M06+ GV2 AE11					
5	-F1	Automatsälkring Miniature Circuit Breaker Automatsicherung	3P C 10A	Merlin Gerin	24466					
6	-UG1	Transformator Transformer	3x480V AC/24VDC, 5A	PULS	SL5.300					
7	-KM1	Kontaktor Contactor	7,5kW	Telemecanique	LC1D18BD					
8	-KM2	Kontaktor Contactor	4kW	Telemecanique	LP1K 0910 BD					
9	-KA1	Relä + Sockel Relay + Socket	2 AUX	Releco	C7A20DX24D+ S7-IO					
10	-KA2	Relä + Sockel Relay + Socket	2 AUX	Releco	C7A20DX24D+ S7-IO					
11	-KA3	Relä + Sockel Relay + Socket	2 AUX	Releco	C7A20DX24D+ S7-IO					
12	-X1	Plint Socket Klemme		Weidmuller	WDU					
13		Montageskena	600 mm							
14		Material för medleverans								
15	-SA1	Belyst Vred Illuminated Selector switch	2-läges, Grön	Telemecanique	XB4-BK123B5+ ZBZ33				SKYLT TEXT=FAN 0 1	
16	-SA2	Belyst Vred Illuminated Selector switch	3-läges, Grön	Telemecanique	ZB4-BK1333+ ZBZ33				SKYLT TEXT=PUMP OFF MAN AUTO	
17		Kontaktton	24VDC, 2 SL, Grön	Telemecanique	XB4BVB3 + 2ST ZBE101					
18										

Line	Item	Denomination	Technical Data	Manufacturer	Type No.	Order No. E-number	Sheet ref.	Index	Remark	Rev.
19		5m Ölflex classic 150 4x2,5				E				
20		1m Ölflex classic 150 4x1,5				E				
21		1,5m Ölflex classic 110 7x0,75				E02 832 45				
22		2st Thorsman tet 10-14				E14 580 23				
23		2st M32				E14 761 15				
24		1st Mutter M32				E14 765 35				
25		1st PG9				E14 588 15				
26		1st PG11 till PG9				E14 643 18				
27		1st Blindplugg 22,5				E14 661 62				
28		3st Mutter 22,5				E14 654 62				
29		5m PMA slang				E14 100 30				
30		2st 90gr förskruvning				E14 106 54				
31		1st förskruvning IP68	BVNV-P167GT-11 IP68							
32		1st Nivågivare	MSK4-MS-R1,0-SOS-0200	OEM		689.1249.004				
33		1st mutter G25								
34										
35										
36										
37										
38										
39										
40										