

POWER SUPPLY
35 A

FAN
7,5 kW

PUMP
0,75 kW

CONTROL VOLTAGE
24VDC

REV.	DESCRIPTION	SIGN.	DATE

ABSOLENT AB
ODR3000 UL
SPRAY/PUMP TIME LIMIT


JE Automation


DESIGN: AW
DATE: 2005-05-26

DRAWN: AW
APPR: KEJO

ESTABL.:
DEPT.: +AS1

STATUS AS BUILT	CONT. SH. 2	SHEET 1
DRW. NO. 934_8	REV.	

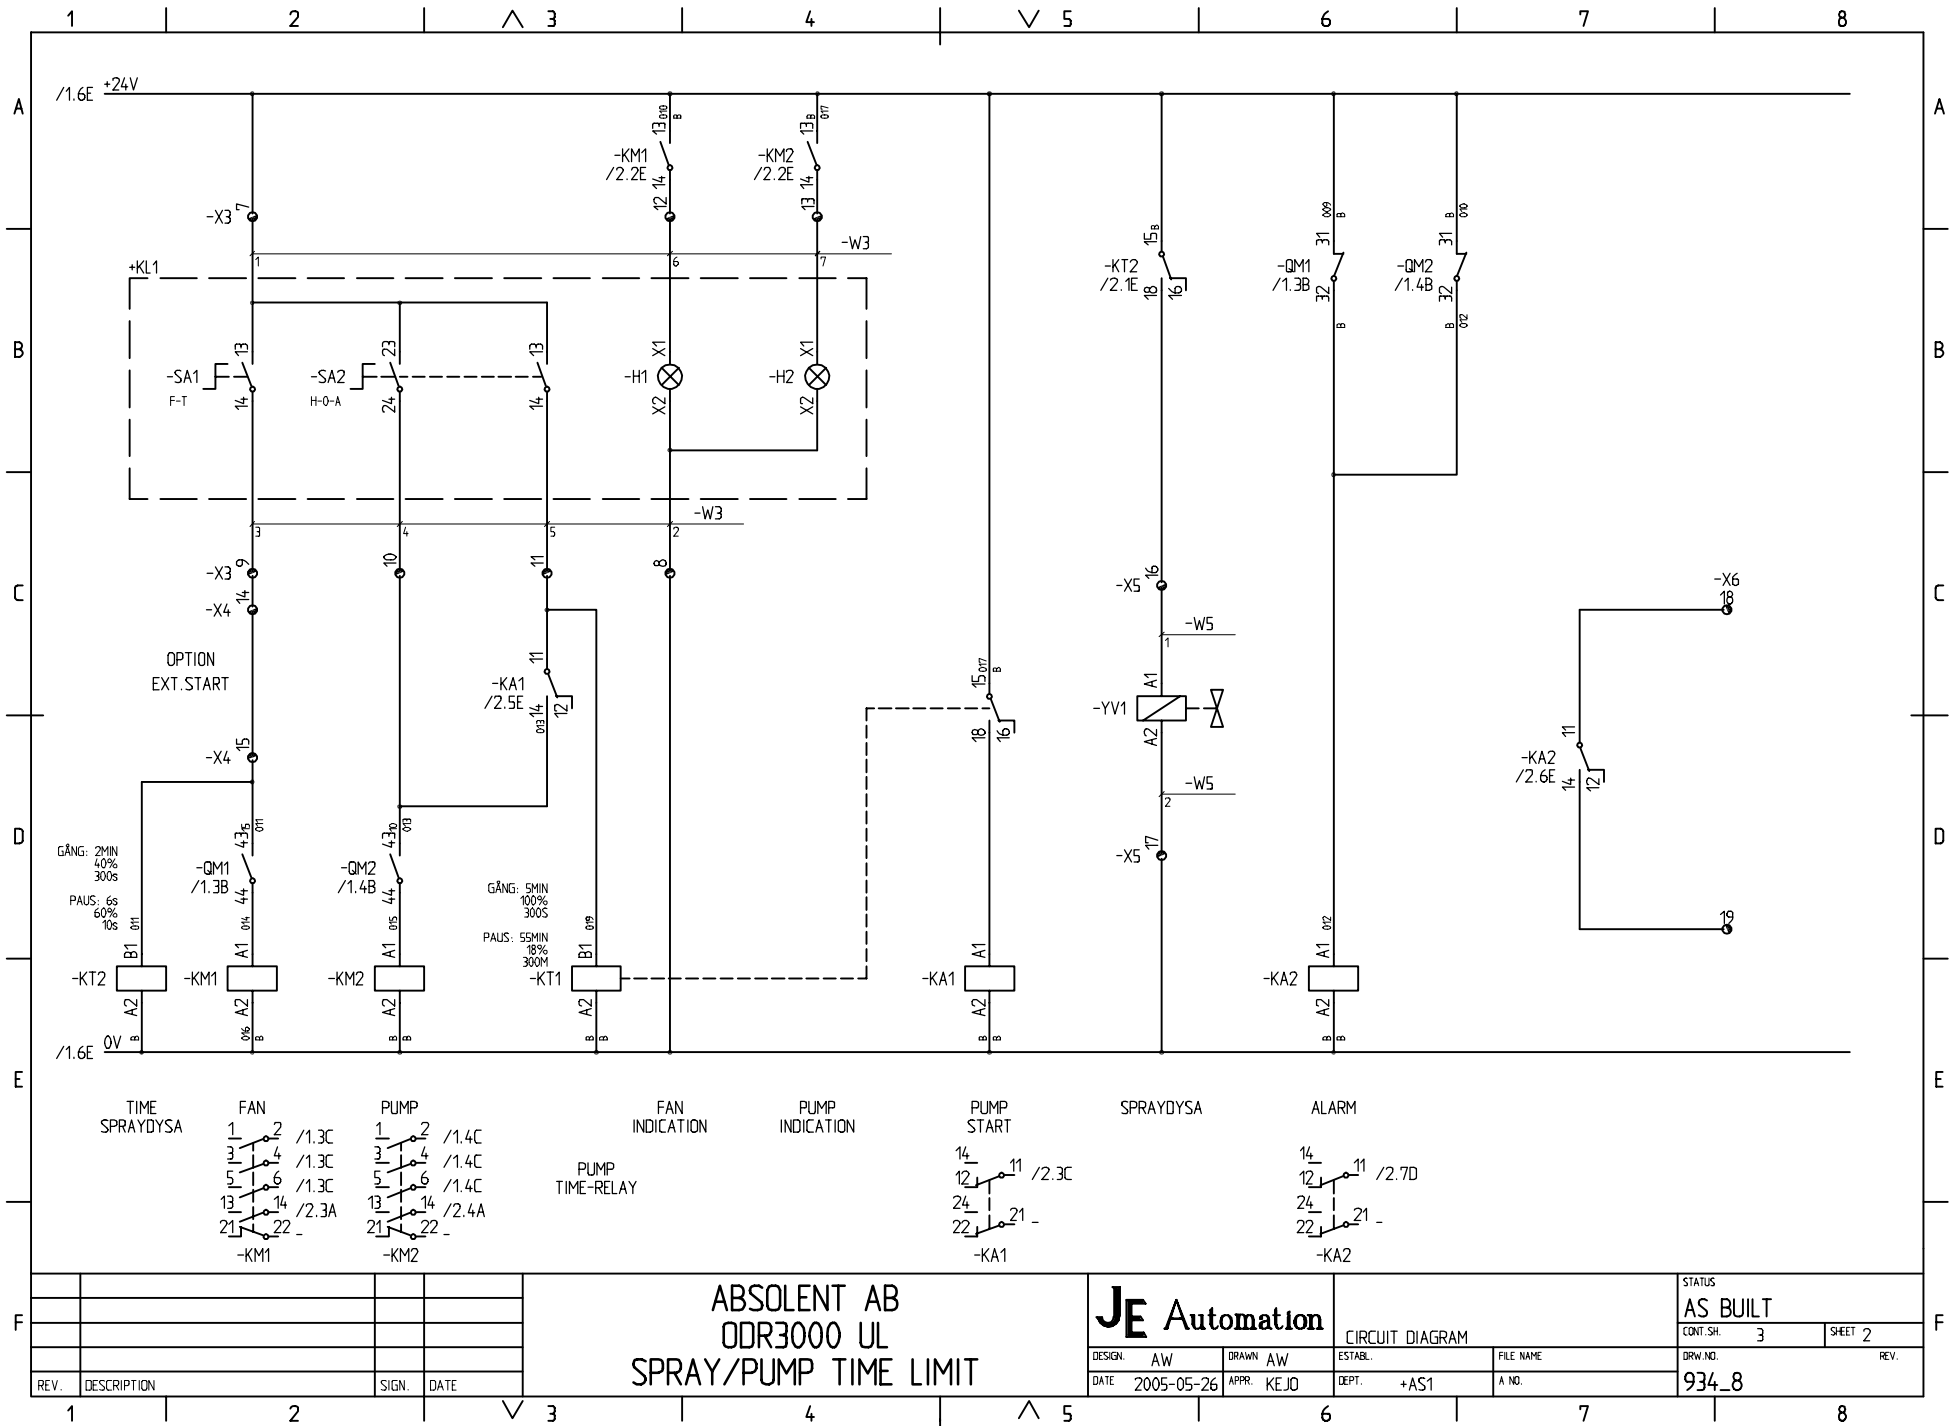

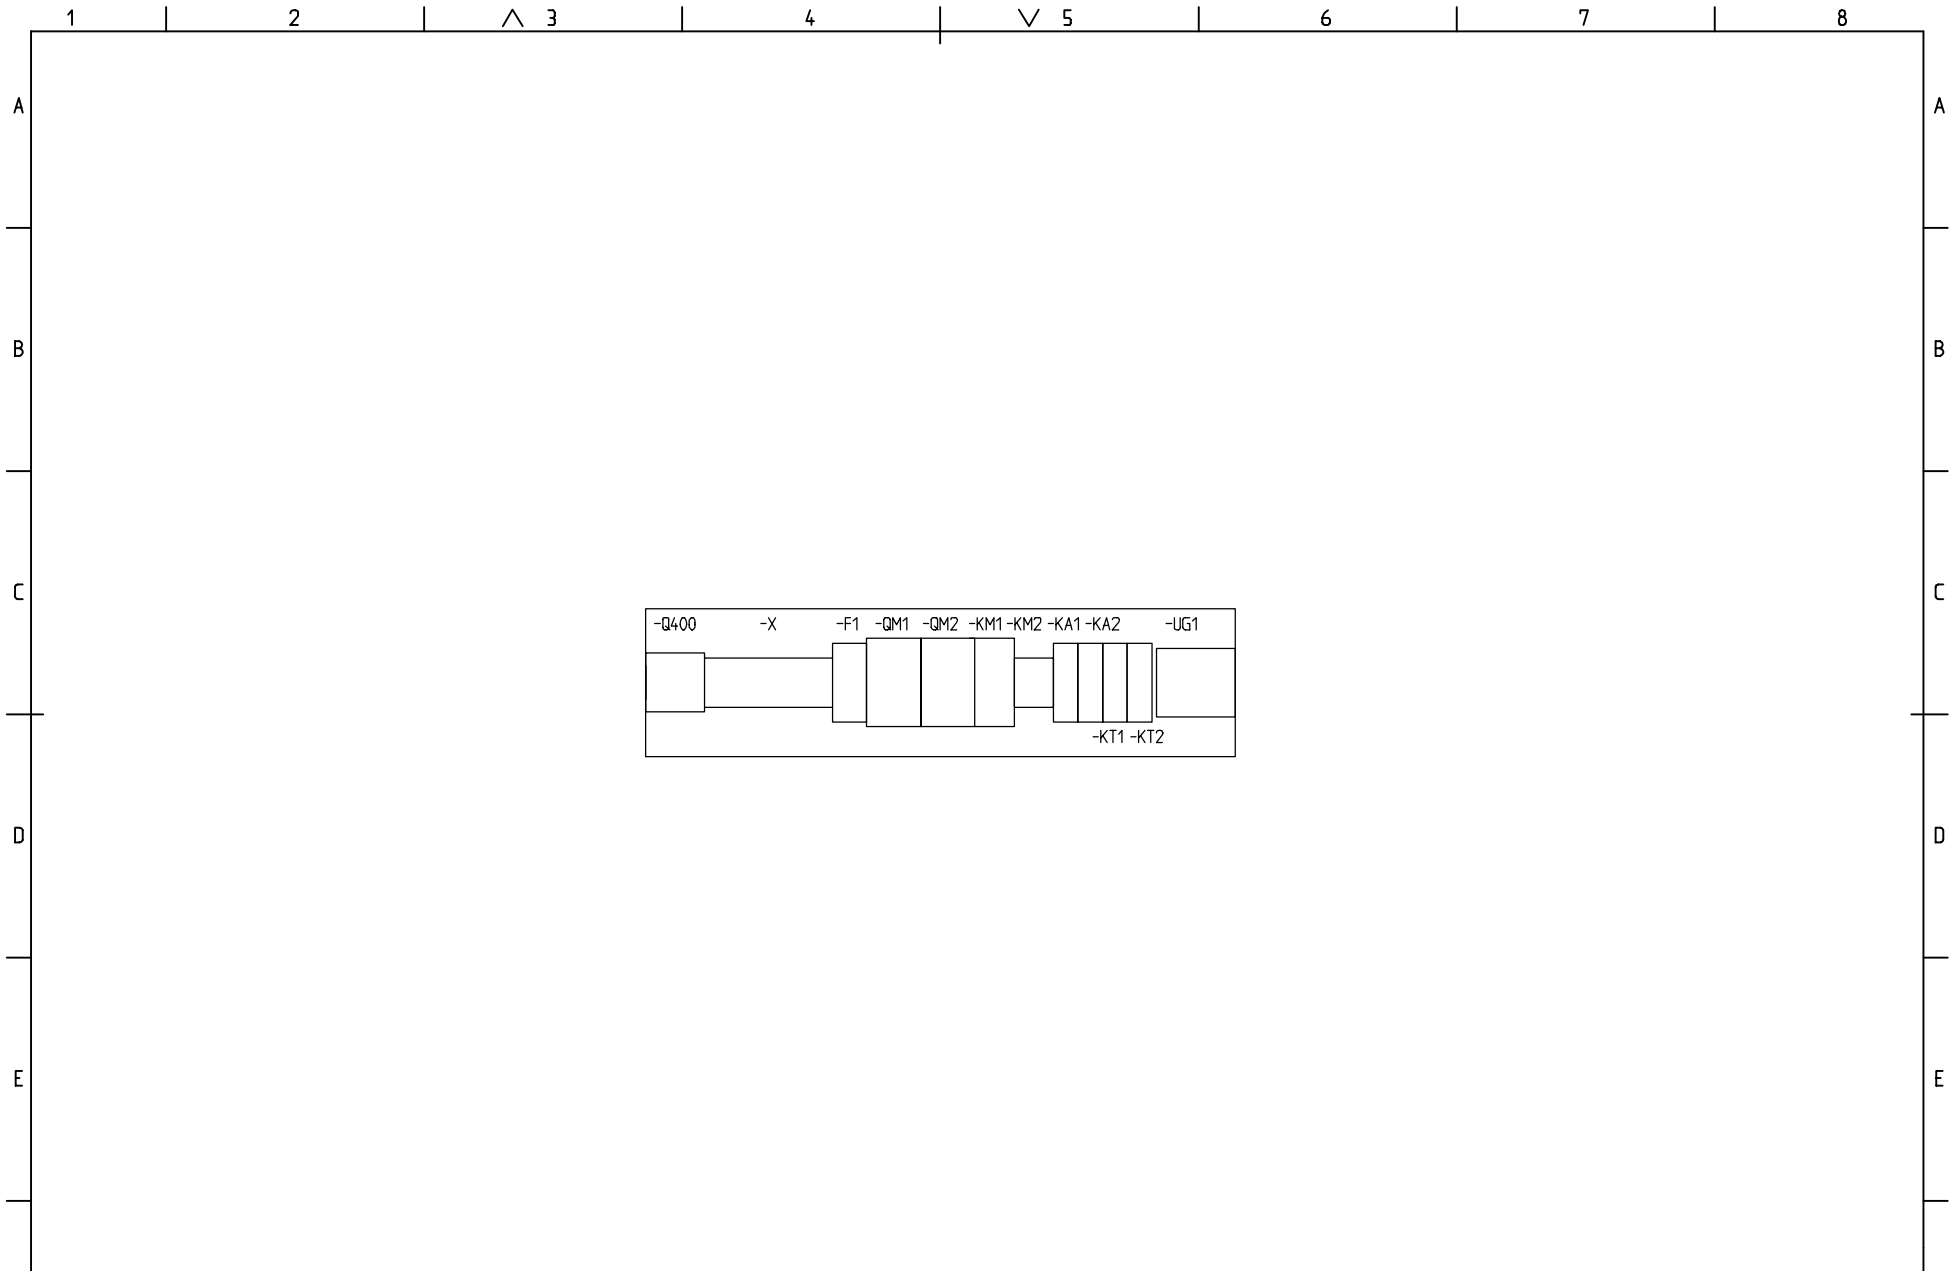

ABSOLENT AB
ODR3000 UL
SPRAY/PUMP TIME LIMIT


JE Automation

LAYOUT

STATUS	
AS BUILT	
CONT. SH.	4
SHEET	3
DRW. NO.	934_8
REV.	

REV.	DESCRIPTION	SIGN.	DATE

DESIGN.	AW	DRAWN	AW	ESTABL.		FILE NAME	
DATE	2005-05-26	APPR.	KEJO	DEPT.	+AS1	A NO.	

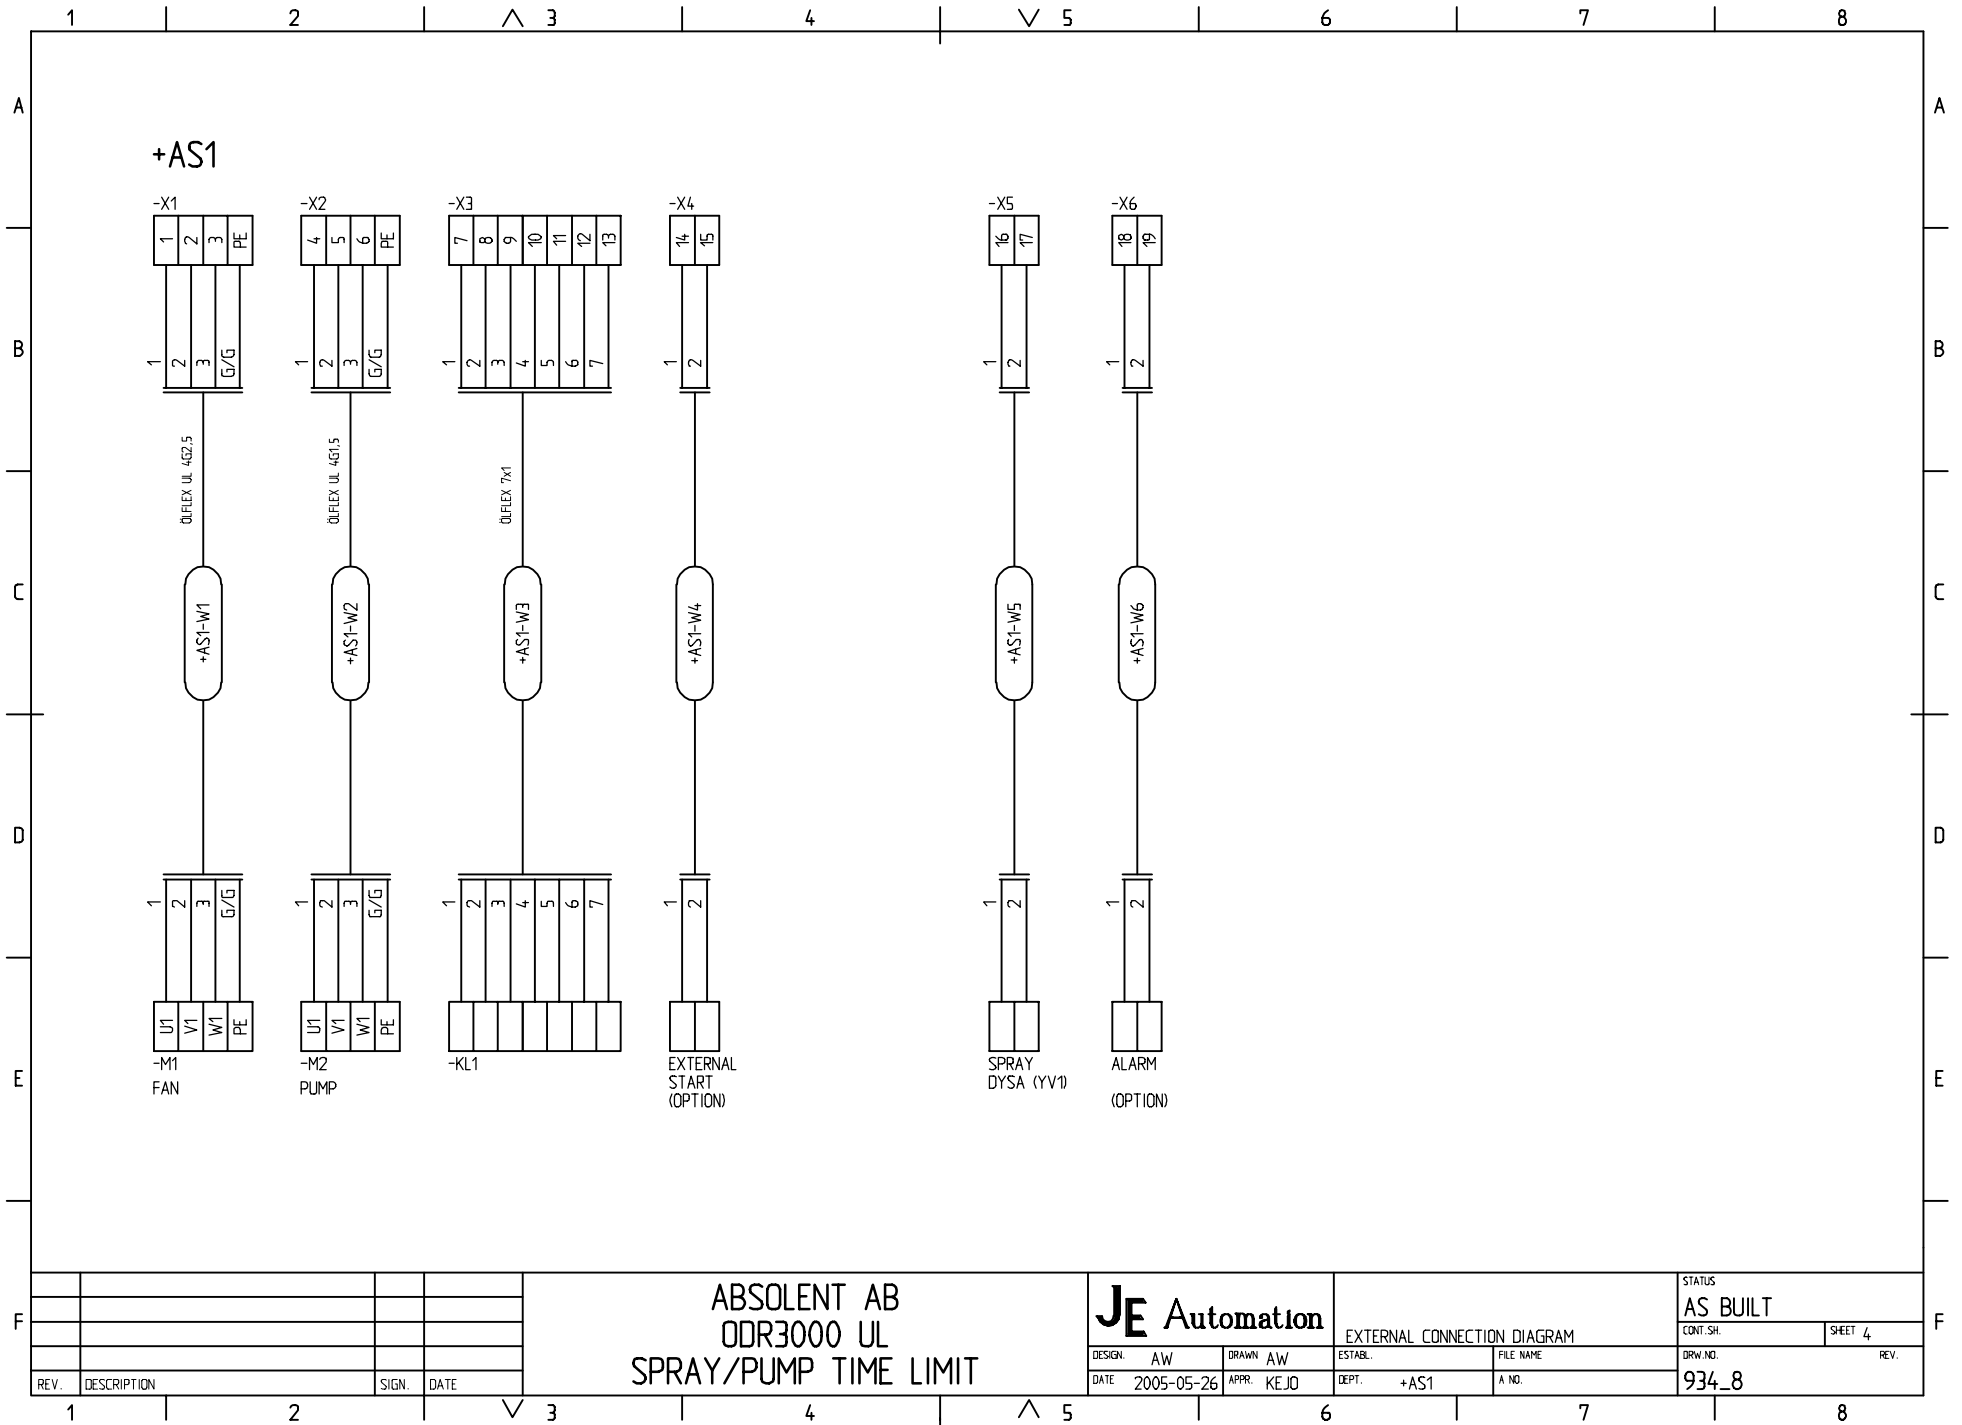

ABSOLENT AB
ODR3000 UL
SPRAY/PUMP TIME LIMIT



EXTERNAL CONNECTION DIAGRAM

STATUS AS BUILT	
CONT. SH.	SHEET 4
DRW. NO.	REV.
934_8	

REV.	DESCRIPTION	SIGN.	DATE

DESIGN. AW	DRAWN AW	ESTABL.	FILE NAME
DATE 2005-05-26	APPR. KEJO	DEPT. +AS1	A NO.