


Please provide booth wall panel detail /framing so I can check if I can use this as a ducting support

Please confirm. The base plate of the welding booth panels that I saw at Chevron it seems different with this detail. What I saw has a square base plate with four holes at each end of the panes. I am not sure if this for the bottom or for top connection

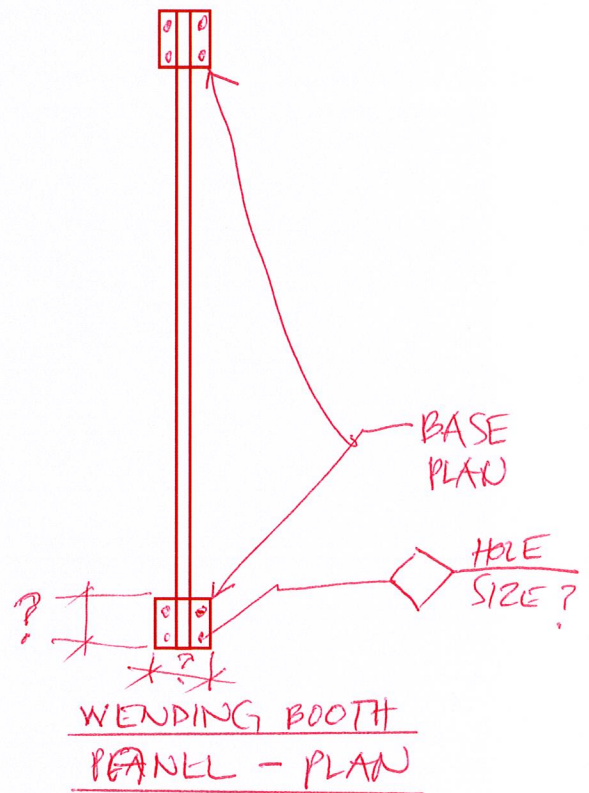

This is levelling bolt detail, this is not the panel mounting detail, please confirm

THIS IS THE FUME HOOD SUPPORT, IT CLEARLY SHOWS THAT THERE IS NO DUCT SUPPORT

AVANI ENVIRONMENTAL INTL. INC. Sales Department 95 Cypress Drive Youngsville, NC 27596 (919) 570-2862 info@avanienvironmental.com	Date	Name	Part Number:	Title:
	2012-02-16	***	***	Booth WB-1066
The drawings, AutoCAD, 3-D Models, and specifications are the property of Avani Environmental Intl. Inc. (AE) and may not be reproduced, distributed, modified, or otherwise used, except provided herein, without the express written permission of AE.	Checked by:		Size	Scale
			A	1 = 25
			Drawing Number:	
			WB-6x6S standard	

1. please provide base plate detail.
2. Please provide values with "?"
3. please provide BASE PLATE THICKNESS.
4. BASE PLATE MATERIAL SPECS, ASTM