
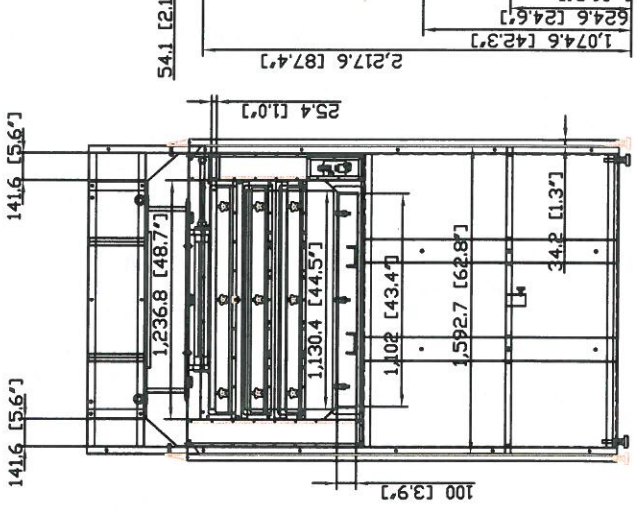


DO NOT SCALE IF IN DOUBT ASK

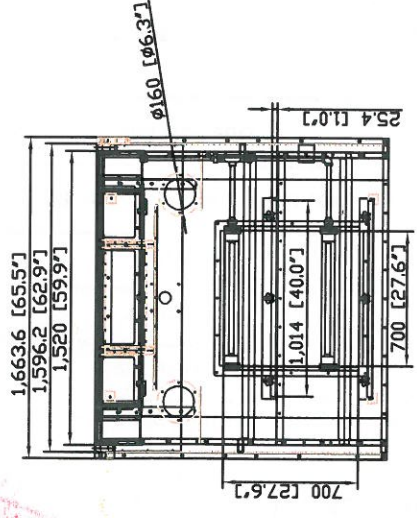

WB-5055 (DW walls) WELDING BOOTH SPECIFICATIONS

- Hood Dimensions: 60" x 60" x 8.5"
- Back Draft Dimensions: 48.7" x 35.9" x 9.2" (incl. clean out drawer)
- Hood Inlet Opening: 6" x 19.9" (119.4 square inches)
- Hood Service Panel: Removable 27.6" x 27.6" service panel
- Back Draft Adjustable Inlet Slots: (3) 1" x 44.5"
- Hood Adjustable Inlet Slots: (2) 1" x 40"
- ***Overhead Lights: (2) Explosion Proof Lights (110V, Single Phase, 60 Hz, 20W, non-recessed)
- Adjustable Knobs: (15) 2 1/2 Five Star Twists
- Clean Out Drawer: 3.9" x 43.4" (ID) with (3) hand twist locks
- Adjustable Level System: (6) 2 1/2 Feet (maximum adjustment 5")
- Support Structure: 1 1/2 x 4" steel stock welded
- Panel Construction: 14-gauge welded steel single wall with cross and up bracing
- Rear Support: (2) 12" x 19" 30 degree gussets for overhead piping and accessories
- Welding Curtain Supports: (2) adjustable welding curtain brackets
- Lifting Lugs: (4) Hood mounted lifting lugs to set and move hood or booth
- Fume Arm Ceiling Supports & Brackets: Built into the hood
- Fume Arm Cover Plates: (2) cover plates (6 bolt pattern) to match optional dia. 6" fume arm
- Powder Coated: Avani Safety Blue Standard (custom colors available)
- Five Piece Configuration: (2) side panels, (1) back panel, (1) backdraft assembly, (1) hooddraft assembly.

- Booths can be mounted back-to-back, side-to-side or both options

***Double Wall Construction (welded)

***Adjustable Back Shelf: 62.7"W x 17.6"D x 1.1"H (solid with 2" hole drilled)

***Light Conduit

***Light Switch

OPTIONS

- Welded Nuts: Optional locations for J-hooks
- Welding Nuts: For wire feeder or welder bracket
- Adjustable Rear Shelf (solid, grate or cutting table)
- Corner Shelves
- Viewing Windows
- Custom Welding Brackets
- Foot Lockers
- Fixtures, Lazy Suzans
- Any option that can fit inside the booth

NO EXCEPTION TAKEN REVISE AND RESUBMIT REJECTED FURNISH AS CORRECTED

Corrections or comments made on the shop drawings during this review do not relieve contractor from compliance with requirements of the drawings of specifications. This check is only for review of general conformance with the design concept of the project and general compliance with information given in the contract documents. The contractor is responsible for confirming and correlating all quantities and dimensions, selecting fabrication techniques of the booth and coordinating his work with that of all other trades and performing his work in a safe and satisfactory manner.

Title: **MOSS ARCHITECTS, INC.**
 DATE: *9/15/11* **WB-5055 (DW walls) DM**

Part Number: **

Drawn by: 2011-02-08
 Checked by: 2010-11-16

The drawings, AutoCAD, 3-D Models, and specifications are the property of Avani Environmental Int'l. Inc. (AE) and may not be reproduced, distributed, modified, or otherwise used, except provided herein, without the express written permission of AE.

AVANI ENVIRONMENTAL INTL. INC. Sales Department
 95 Cypress Drive
 Youngsville, NC 27596
 (919) 570-2862
 info@avanienvironmental.com

Size: **A** Scale: 1 = 35 Drawing Number: WB-5-5 standard